

Central Pacific Engineering, Inc.

Professional Electrical Engineering and Design

PO Box 1727
Capitola, CA 95010
T: 831-476-1525

08-10-15
CPE #15-024-0

Alimur Mobile Home Park - HOA
4300 Soquel Dr,
Soquel, CA 95073
Ph: 831-475-0252

Attn: David Loop, APHOA Purchase Attorney
Ph: 831-688-1293
Email: deloop1@sbcglobal.net

Subject: Site Electrical Evaluation

Dear HOA Board of Directors,

Alimur Mobile Home Park is in the process of converting to a resident owned park. The park was originally constructed as a 1957+/- vintage recreational vehicle (RV) park with a 208/120V, three phase main electrical service. At some point in time the park was expanded adding additional spaces fed from the same main electrical service.

We understand the park has applied to PG&E for gas & electric infrastructure upgrade program.

The following is our report, relative to the above subject project, for our site visit referred to our office by yourself.

Purpose: This purpose of this report is to evaluate, document the existing park electrical distribution system and prepare a report of our findings. Our site evaluation work included walking the park and opening up main electrical panels to observe and develop an overview understanding of the electrical system condition. Site assessment studies are a overview review of the existing electrical system. A detailed, more in depth review is beyond the scope of services and often difficult since portions of the electrical system are not directly observable without dismantling and/or destructing portions of the electrical system.

Site Investigation:

Date: primary dates July 28 & 29, 2015, follow up date August 3, 2015
Place: Alimur Mobile Home Park, 4300 Soquel Dr., Soquel, CA
Persons present: David Smith & Staff – Central Pacific Engineering, Inc.

Site Observations – Power Distribution:

Main Service: 208/120V, 800amp, three phase main electrical service master PG&E utility meter serving the majority of the park. Several additional PG&E meters exist to serve the House and Garage structures, space 101A, space 200, and space 23A with empty meter socket but connected to PG&E. The main service that serves the park has nineteen (19) fused disconnects for seventeen distribution feeders serving spaces 1-104 in groups of two to nine spaces and two additional feeders to serve the office/clubhouse and laundry room/recreation building. A 400amp fused disconnect is tapped off of the main bus to serve the park expansion spaces #201-237.

The park's electrical system was designed in 1957 to support 120/208V or 120-240V, 3,600watt per lot load, with 50amp max service to homes. This was in accordance with the first regulations effective July 14th, 1956 and prior to August 17th, 1969 when the regulations changed requiring 16,000watts per lot.

The seventeen distribution feeders for spaces 1-104 feed panels & meters located in meter cabinet structures throughout the park. The original construction consisted of a branch circuit panel feeding individual meter sockets, one for each space. Over the years it appeared in some of the meter cabinets this scheme had been modified by the addition of individual circuit breakers, some tapping the main feeder & others not, and in some cases abandoning the meter and using a meter pedestal to serve the space.

This assembly method of meter cabinet structures with a separate panel and meter sockets is an older practice which is being replaced with an individual self contained weatherproof rated meter main panels when the cabinets become dilapidated or the park is modernizing.

For the age of the park **the meter cabinet equipment is usable for the short term but should be incorporated into the reserve study to be replaced should the PG&E infrastructure upgrade program work not materialize.**

Panels in the office /clubhouse, laundry room / recreation building should be incorporated into the reserve study to be replaced since they would not be abolished as part of the PG&E infrastructure upgrade program work.

We observed the supplemental ground at each meter cabinet was bonded with a metal armor jacketed solid copper ground conductor without the appropriate connector to clamp the armor jacket to the grounding rod or panel. **We recommend this be corrected.**

Various wiring methods are used feed spaces 1-104 from these meter cabinets. Spaces with individual meter pedestals were documented on the attached electrical drawings.

We observed no electrical service for space 23 and space 23A tapped on the PG&E feeder lugs in the PG&E CT meter section. We recommend this tap be removed and both spaces be rewired to panel 4 serving spaces 17 & 18.

Spaces 201-237 are fed from a 208V to 240V transformer and panels denoted as Panel A, Panel B, & Panel C. These panels have two or three feeder breakers that typically serve 6 spaces. Each space has an individual meter pedestal for the home connection.

We prepared a site plan, one-line drawing, and panel schedules with meter cabinet elevations documenting our observations.

Site Observations – Site Lighting:

The mobile home park act Title 25, section 1108 requires an average 0.2 foot-candles of light the full length of all roadways, walkways, during the hours of darkness. An average 5 foot-candles is required for toilet, shower, laundry, and recreation building entrances when the buildings are in use during the hours of darkness. The code references an "Average" therefore some areas may be dark while other areas are heavily lighted and only applies to the specific area (ie: paved roadway, designated walkways and entrance areas) and not the surrounding areas (ie: adjacent landscape areas).

A night time site visit or photometric lighting study was not part of this study therefore compliance was not be verified.

The lights we observed while walking the park we documented on the site drawing we prepared. The layout appeared to be supplemented with additional lighting from the original construction and typical for parks of this vintage. Various times clocks were observed throughout the park to control the exterior site lighting. Most fixtures observed had screw in fluorescent lamps which provide respectable energy savings. LED replacement should be considered for long term maintenance planning.

Recommend incorporating long term LED lighting replacement into the reserve study.

Conclusion:

Minor corrections noted above in “**bold**” text should be addressed as noted.

We thank you for the opportunity to perform this investigation-evaluation for you and the Association. Should you or any of your associates have any additional questions or requirements, please feel free to contact this office. Again thank you.


Cordially,
Central Pacific Engineering, Inc.



David G. Smith, P.E.
Electrical Engineer
CA-E13492, exp. 09-30-16

DGS/dgs



Enclosures: Electrical Drawings E1.00, E4.00, E4.10, E4.20, E4.30

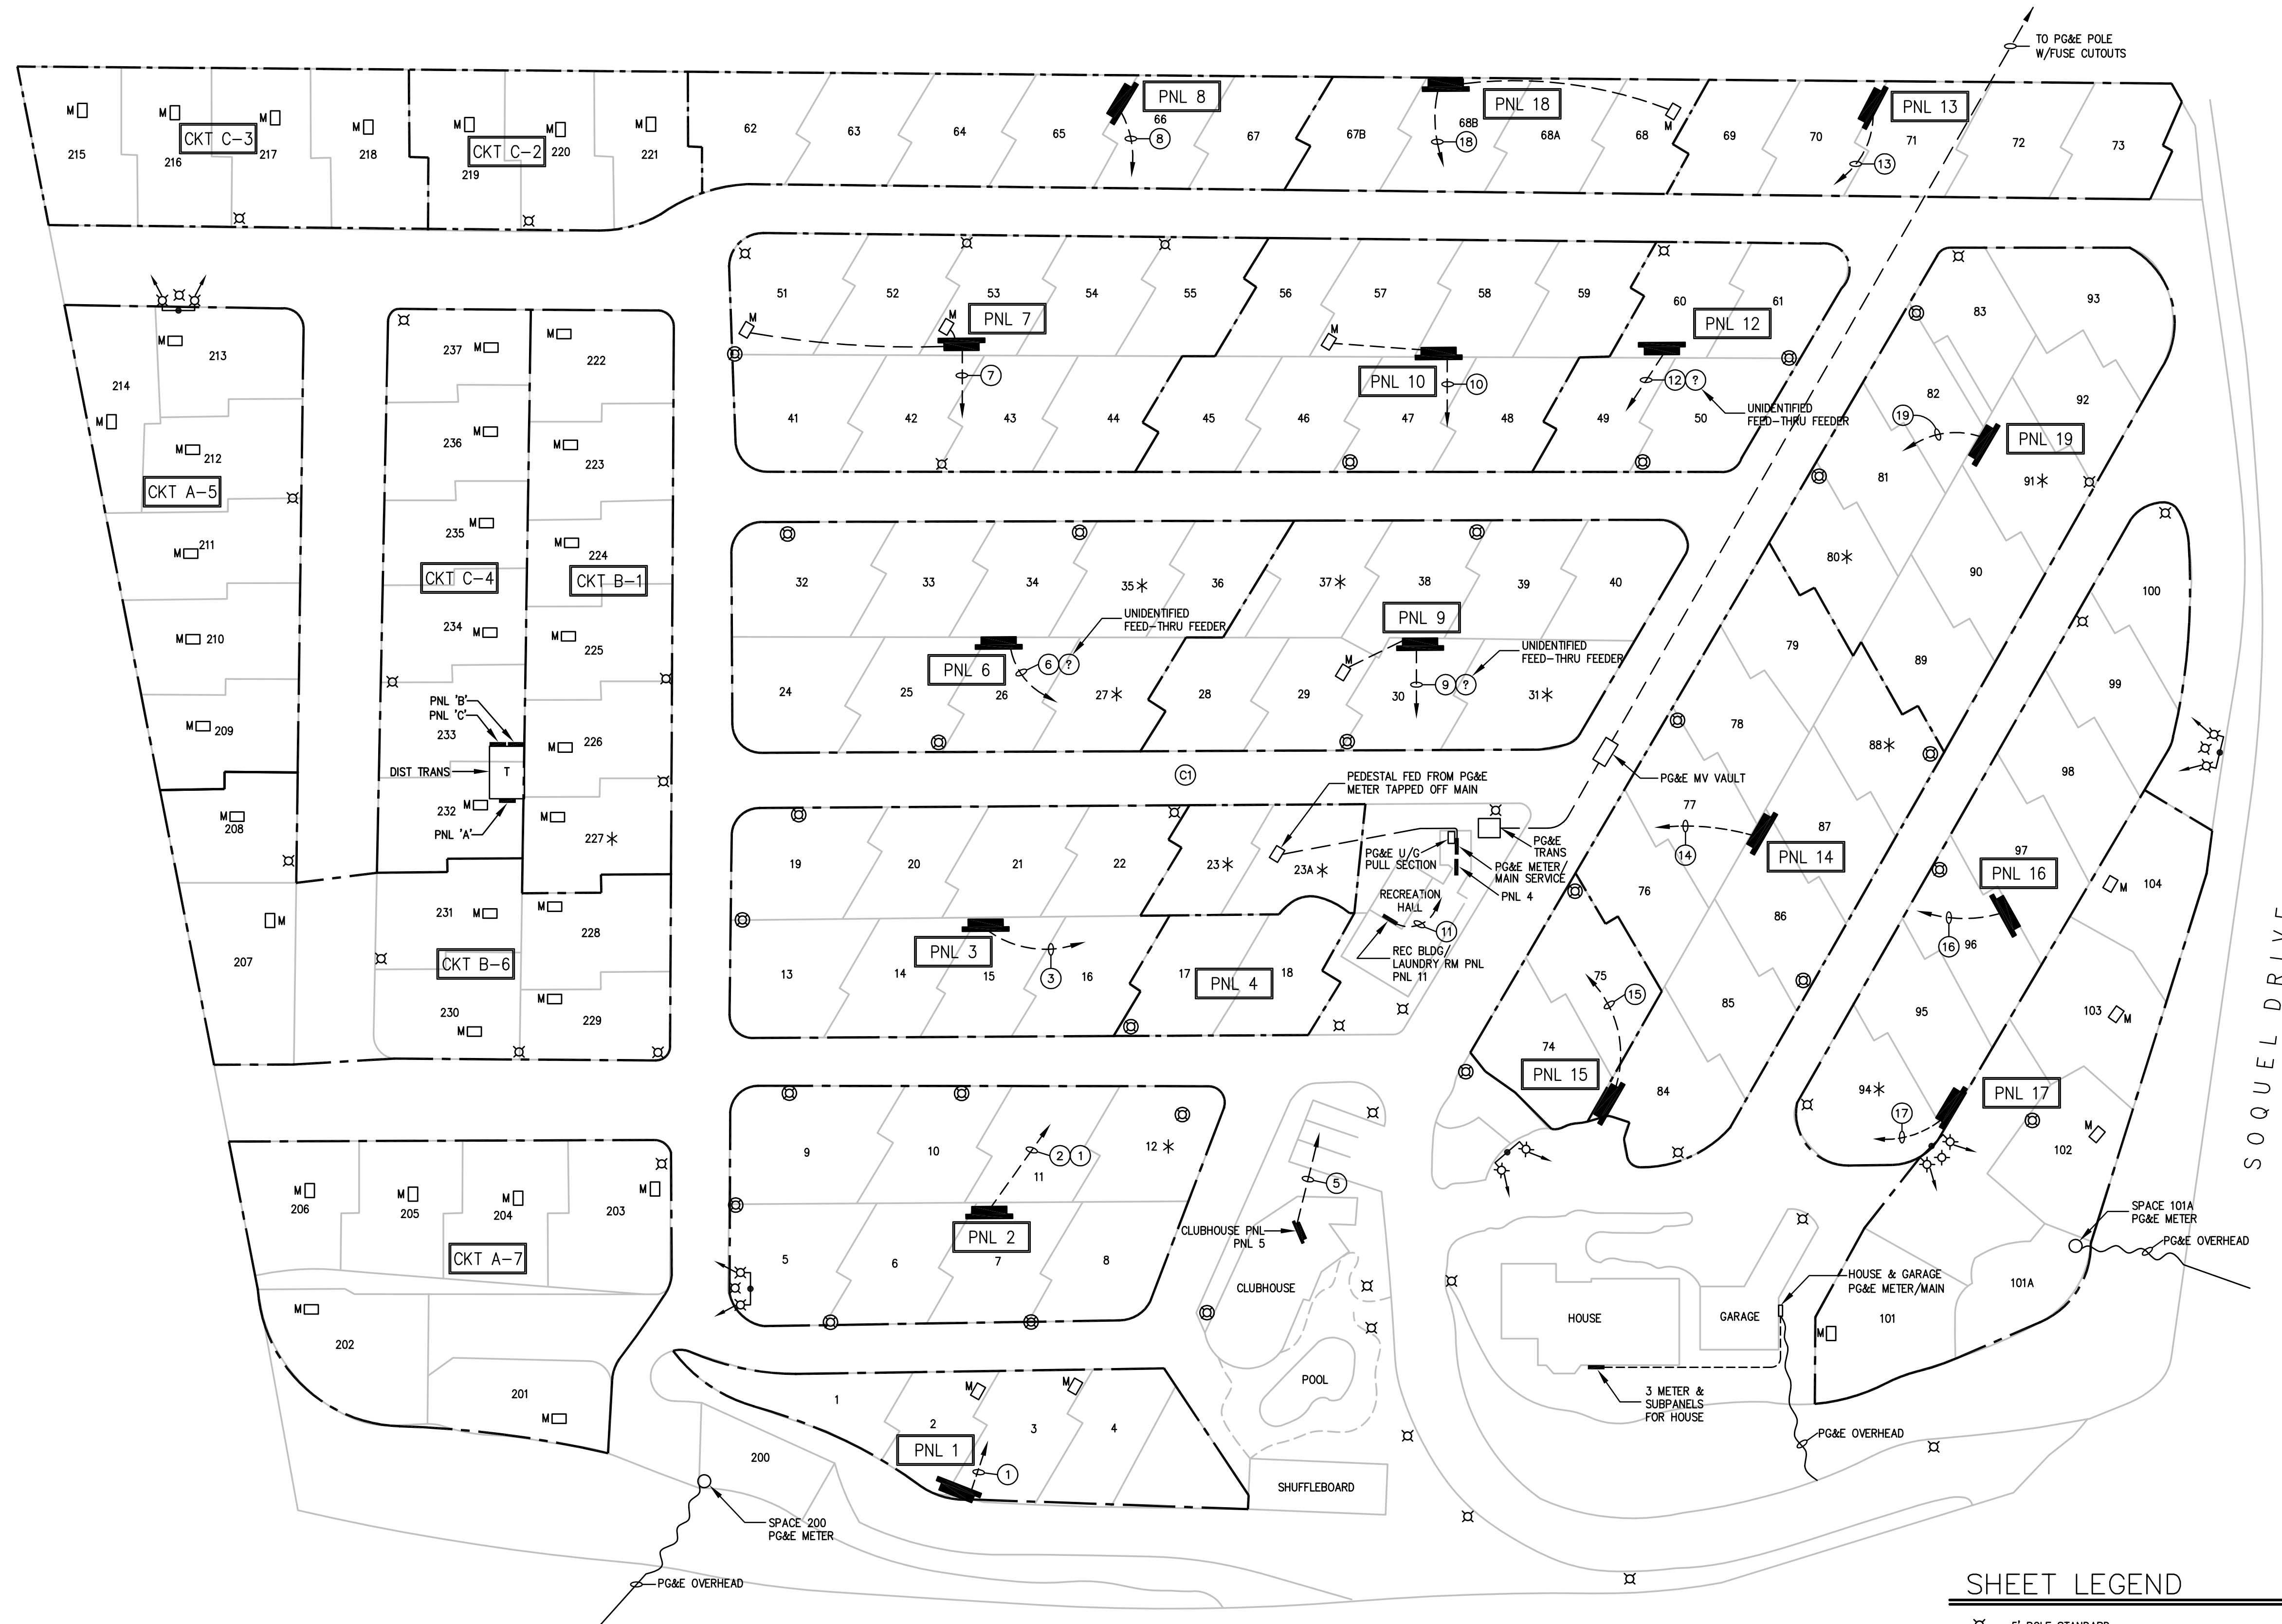

1 ELECTRICAL SITE PLAN
SCALE: 1" = 40'-0"


SHEET LEGEND

- ⊗ 5' POLE STANDARD
- ⊙ BOLLARD 24"±
- ⚡ POLE W/FLOOD LIGHTS
- ⊠ METER PEDESTAL
- * VACANT SITE
- ① FEEDER TAG/ CIRCUIT #

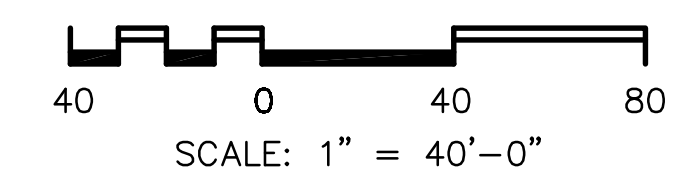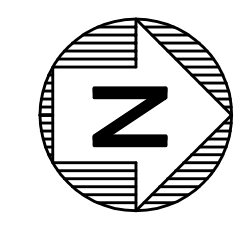

ELECTRICAL SITE PLAN

PROPRIETARY DATA
THE USE OF THE PLANS AND SPECIFICATIONS IS RESTRICTED TO THE PROJECT FOR WHICH THEY WERE PREPARED AND PUBLICATION THEREOF IN ANY MANNER OR BY ANY MEANS WITHOUT THE WRITTEN CONSENT OF CENTRAL PACIFIC ENGINEERING, INC. IS PROHIBITED. WHETHER THE PROJECT FOR WHICH THE PLANS AND SPECIFICATIONS WERE PREPARED OR NOT, NO PART OF THESE PLANS OR SPECIFICATIONS SHALL BE REPRODUCED OR TRANSMITTED IN ANY FORM OR BY ANY MEANS WITHOUT THE WRITTEN PERMISSION OF CENTRAL PACIFIC ENGINEERING, INC. COPYRIGHT 2008

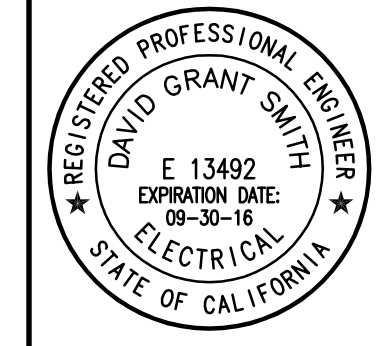

Central Pacific Engineering, Inc.
Professional Engineers
P.O. Box 1727, Capitola, CA 95010
831-478-1525
www.cpeinc.com

REV.	DESCRIPTION	DATE
1	SITE EVALUATION	08/10/15

TITLE: ALIMUR MOBILE HOME PARK		DR.	SLM	DATE	08/10/15	CHK.	DGS	SCALE	AS NOTED
JOB NO.: 15-024-0		LOCATION:	4300 SOQUEL DR., SOQUEL, CA 95073	APPD.	DGS				
DWG. NO.: E100		OWNER:							
SH	1	REV.	0						
OF	5								


PANEL NAME: 1		LOCATION: 1		PANEL TYPE: <input type="checkbox"/> PANEL BOARD <input checked="" type="checkbox"/> LOAD CENTER	
VOLTAGE: 208/120		BUS RATING: 100		ENCLOSURE TYPE: NEMA 1	
SHORT CIR RATING: 10 KAIC		BUS TYPE: <input checked="" type="checkbox"/> COPPER <input type="checkbox"/> ALUMINUM		MOUNTING: <input checked="" type="checkbox"/> SURFACE <input type="checkbox"/> FLUSH	
O.C. DEVICES: <input type="checkbox"/> BOLT-ON <input checked="" type="checkbox"/> PLUG-ON		DEVICE FAMILY: <input type="checkbox"/> SUB-FEED CIRCUIT BREAKER - SEE ONE LINE		INTERIOR: <input checked="" type="checkbox"/> MAIN LUGS <input type="checkbox"/> MAIN CIRCUIT BREAKER - SEE ONE LINE	

DESCRIPTION	LTG	SE	VOLT - AMPS	BRK.	CKT NO.	BUS CONN.	CKT NO.	BRK.	VOLT - AMPS	SE	DESCRIPTION
			ΦA ΦB ΦC			A B C			ΦA ΦB ΦC		
1					1						SPACE 1
2	X	X	3600		2						SPACE 1
3					4				1800		SPACE 4
4					6				1800	X	SPACE 4
5					8						
6					10						
7					12						
8					14						
9					16						
10					18						
11					20				3600 1800 1800		
12											
13											
14											
15											
16											
17											
18											
19											
20											

TOTALS: 0 0 0 3600 1800 1800

BUS A 3.6 KVA
BUS B 1.8 KVA
BUS C 1.8 KVA
TOTAL 7.2 KVA

SPACES 2 & 3 HAVE METER PEDESTALS

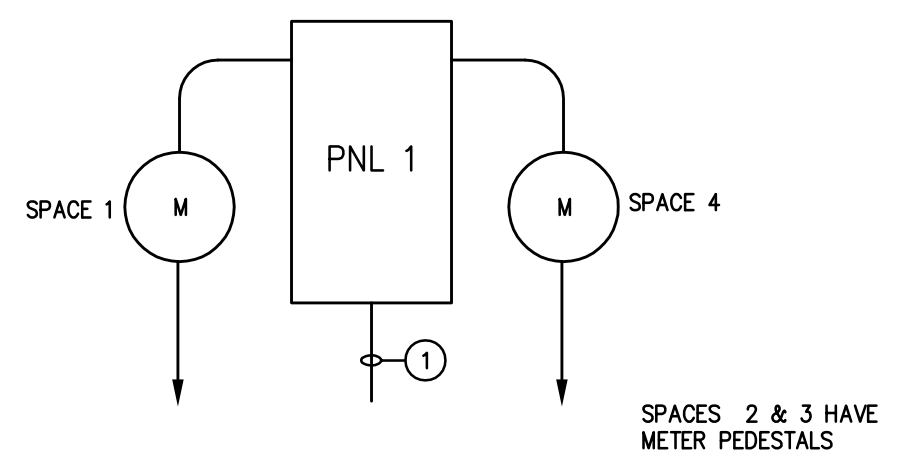


METER CABINET #1

PANEL NAME: 2		LOCATION: 2		PANEL TYPE: <input type="checkbox"/> PANEL BOARD <input checked="" type="checkbox"/> LOAD CENTER	
VOLTAGE: 208/120		BUS RATING: 100		ENCLOSURE TYPE: NEMA 1	
SHORT CIR RATING: 10 KAIC		BUS TYPE: <input checked="" type="checkbox"/> COPPER <input type="checkbox"/> ALUMINUM		MOUNTING: <input checked="" type="checkbox"/> SURFACE <input type="checkbox"/> FLUSH	
O.C. DEVICES: <input type="checkbox"/> BOLT-ON <input checked="" type="checkbox"/> PLUG-ON		DEVICE FAMILY: <input type="checkbox"/> SUB-FEED CIRCUIT BREAKER - SEE ONE LINE		INTERIOR: <input checked="" type="checkbox"/> MAIN LUGS <input type="checkbox"/> MAIN CIRCUIT BREAKER - SEE ONE LINE	

DESCRIPTION	LTG	SE	VOLT - AMPS	BRK.	CKT NO.	BUS CONN.	CKT NO.	BRK.	VOLT - AMPS	SE	DESCRIPTION
			ΦA ΦB ΦC			A B C			ΦA ΦB ΦC		
1					1						SPACE 8
2	X	X	3600		2						SPACE 8
3	X	X	3600		4				1800		SPACE 7
4	X	X	3600		6				1800		SPACE 7
5	X	X	3600		8				1800		SPACE 6
6	X	X	3600		10				1800		SPACE 6
7	X	X	1800		12				500	X	TIME CLOCK/ SITE LTS
8	X	X	1800		14						
9	X	X	1800		16						
10	X	X	1800		18						
11	X	X	1800		20						
12											
13											
14											
15											
16											
17											
18											
19											
20											

TOTALS: 5400 5400 3600 5400 3600 2300

BUS A 10.8 KVA
BUS B 9.0 KVA
BUS C 5.9 KVA
TOTAL 25.7 KVA

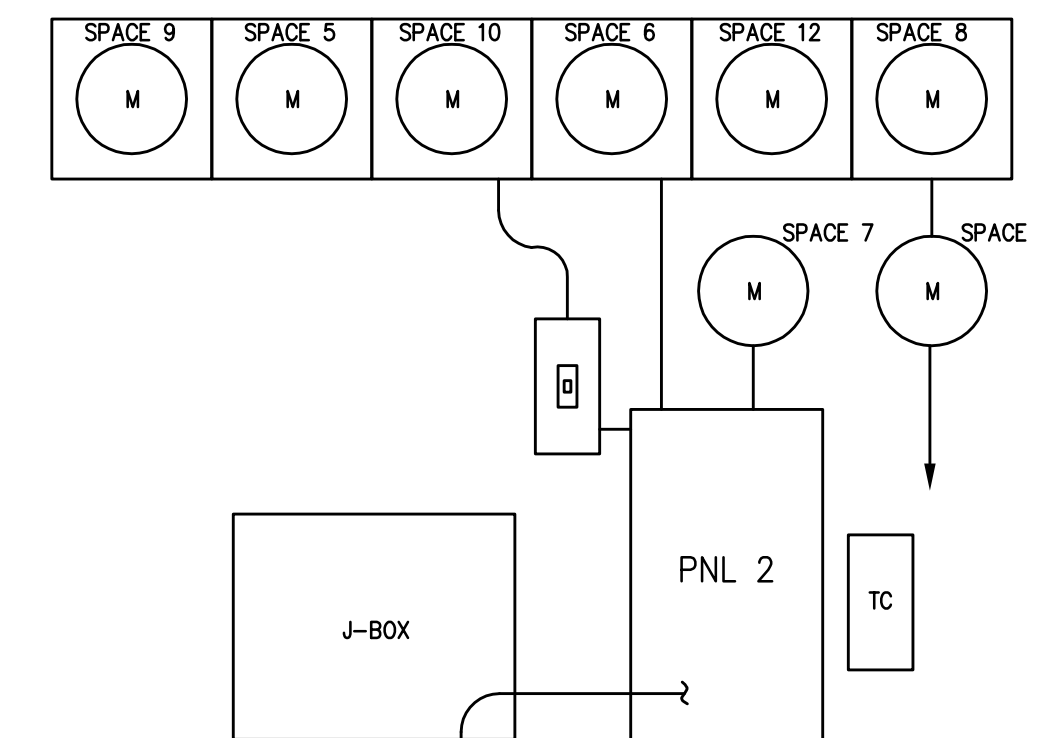


METER CABINET #2

PANEL NAME: 3		LOCATION: 3		PANEL TYPE: <input type="checkbox"/> PANEL BOARD <input checked="" type="checkbox"/> LOAD CENTER	
VOLTAGE: 208/120		BUS RATING: 100		ENCLOSURE TYPE: NEMA 1	
SHORT CIR RATING: 10 KAIC		BUS TYPE: <input checked="" type="checkbox"/> COPPER <input type="checkbox"/> ALUMINUM		MOUNTING: <input checked="" type="checkbox"/> SURFACE <input type="checkbox"/> FLUSH	
O.C. DEVICES: <input type="checkbox"/> BOLT-ON <input checked="" type="checkbox"/> PLUG-ON		DEVICE FAMILY: <input type="checkbox"/> SUB-FEED CIRCUIT BREAKER - SEE ONE LINE		INTERIOR: <input checked="" type="checkbox"/> MAIN LUGS <input type="checkbox"/> MAIN CIRCUIT BREAKER - SEE ONE LINE	

DESCRIPTION	LTG	SE	VOLT - AMPS	BRK.	CKT NO.	BUS CONN.	CKT NO.	BRK.	VOLT - AMPS	SE	DESCRIPTION
			ΦA ΦB ΦC			A B C			ΦA ΦB ΦC		
1	X	X	3600		1						SPACE 23
2	X	X	3600		2				3600		SPACE 22
3	X	X	3600		4				3600		SPACE 22
4	X	X	3600		6				3600		SPACE 21
5	X	X	3600		8				3600		SPACE 20
6	X	X	3600		10				3600		SPACE 20
7	X	X	3600		12				3600		SPACE 19
8	X	X	3600		14						
9	X	X	3600		16						
10	X	X	3600		18						
11	X	X	3600		20						
12	X	X	3600		22						
13	X	X	3600		24						
14	X	X	3600		26						
15	X	X	3600		28						
16	X	X	3600		30						
17	X	X	3600		32						
18	X	X	3600		34						
19	X	X	3600		36						

TOTALS: 5400 7200 2300 7200 3600 7200

BUS A 12.6 KVA
BUS B 10.8 KVA
BUS C 9.5 KVA
TOTAL 32.9 KVA

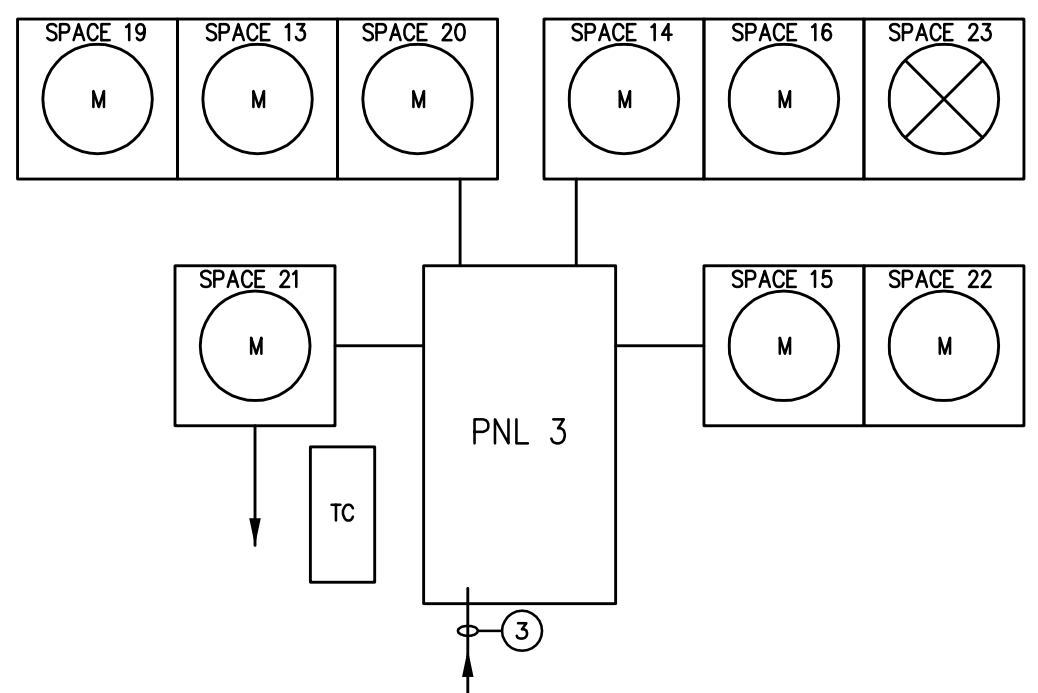


METER CABINET #3

PANEL NAME: 4		LOCATION: 4		PANEL TYPE: <input type="checkbox"/> PANEL BOARD <input checked="" type="checkbox"/> LOAD CENTER	
VOLTAGE: 208/120		BUS RATING: 100		ENCLOSURE TYPE: NEMA 1	
SHORT CIR RATING: 10 KAIC		BUS TYPE: <input checked="" type="checkbox"/> COPPER <input type="checkbox"/> ALUMINUM		MOUNTING: <input checked="" type="checkbox"/> SURFACE <input type="checkbox"/> FLUSH	
O.C. DEVICES: <input type="checkbox"/> BOLT-ON <input checked="" type="checkbox"/> PLUG-ON		DEVICE FAMILY: <input type="checkbox"/> SUB-FEED CIRCUIT BREAKER - SEE ONE LINE		INTERIOR: <input checked="" type="checkbox"/> MAIN LUGS <input type="checkbox"/> MAIN CIRCUIT BREAKER - SEE ONE LINE	

DESCRIPTION	LTG	SE	VOLT - AMPS	BRK.	CKT NO.	BUS CONN.	CKT NO.	BRK.	VOLT - AMPS	SE	DESCRIPTION
			ΦA ΦB ΦC			A B C			ΦA ΦB ΦC		
1					1						SPACE 18
2	X	X	3600		2				1800		SPACE 18
3	X	X	3600		4				1800		SPACE 18
4	X	X	3600		6				1800		SPACE 18
5	X	X	3600		8				1800		SPACE 18
6	X	X	3600		10				1800		SPACE 18
7	X	X	3600		12				1800		SPACE 18
8	X	X	3600		14				1800		SPACE 18
9	X	X	3600		16				1800		SPACE 18
10	X	X	3600		18				1800		SPACE 18
11	X	X	3600		20				1800		SPACE 18
12	X	X	3600		22				1800		SPACE 18
13	X	X	3600		24				1800		SPACE 18
14	X	X	3600		26				1800		SPACE 18
15	X	X	3600		28				1800		SPACE 18
16	X	X	3600		30				1800		SPACE 18
17	X	X	3600		32				1800		SPACE 18
18	X	X	3600		34				1800		SPACE 18
19	X	X	3600		36				1800		SPACE 18

TOTALS: 0 4100 0 1800 1800 0

BUS A 1.8 KVA
BUS B 5.9 KVA
BUS C 0.0 KVA
TOTAL 7.7 KVA

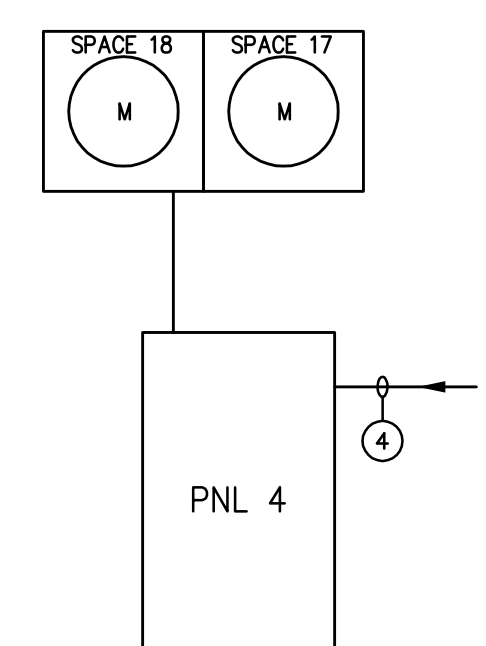

METER CABINET #4

PANEL NAME: 5		LOCATION: 5		PANEL TYPE: <input type="checkbox"/> PANEL BOARD <input checked="" type="checkbox"/> LOAD CENTER	
VOLTAGE: 208/120		BUS RATING: 100		ENCLOSURE TYPE: NEMA 1	
SHORT CIR RATING: 10 KAIC		BUS TYPE: <input checked="" type="checkbox"/> COPPER <input type="checkbox"/> ALUMINUM		MOUNTING: <input checked="" type="checkbox"/> SURFACE <input type="checkbox"/> FLUSH	
O.C. DEVICES: <input type="checkbox"/> BOLT-ON <input checked="" type="checkbox"/> PLUG-ON		DEVICE FAMILY: <input type="checkbox"/> SUB-FEED CIRCUIT BREAKER - SEE ONE LINE		INTERIOR: <input checked="" type="checkbox"/> MAIN LUGS <input type="checkbox"/> MAIN CIRCUIT BREAKER - SEE ONE LINE	

DESCRIPTION	LTG	SE	VOLT - AMPS	BRK.	CKT NO.	BUS CONN.	CKT NO.	BRK.	VOLT - AMPS	SE	DESCRIPTION
			ΦA ΦB ΦC			A B C			ΦA ΦB ΦC		
1	X	X	1200		1						(E) LOAD
2	X	X	1200		2				1500		(E) LOAD
3	X	X	1200		4				1500		(E) LOAD
4	X	X	1200		6				1500		(E) LOAD
5	X	X	1200		8				1200		(E) LOAD
6	X	X	1200		10				1500		(E) LOAD
7	X	X	1200		12				1500		(E) LOAD
8	X	X	1200		14				2500		(E) LOAD
9	X	X	1200		16				2500		(E) LOAD
10	X	X	1200		18				2500		(E) LOAD
11	X	X	1200		20				2500		(E) LOAD
12	X	X	1200		22				2500		(E) LOAD
13	X	X	1200		24				2500		(E) LOAD
14	X	X	1200		26				2500		(E) LOAD
15	X	X	1200		28				2500		(E) LOAD
16	X	X	1200		30				2500		(E) LOAD
17	X	X	1200		32				2500		(E) LOAD
18	X	X	1200		34				2500		(E) LOAD
19	X	X	1200		36				2500		(E) LOAD

TOTALS: 5400 4500 3700 7700 5500 5500

BUS A 13.1 KVA
BUS B 10.0 KVA
BUS C 9.2 KVA
TOTAL 32.3 KVA

OFFICE/CLUBHOUSE - PNL/FDR #5

PANEL NAME: 6		LOCATION: 6		PANEL TYPE: <input type="checkbox"/> PANEL BOARD <input checked="" type="checkbox"/> LOAD CENTER	
VOLTAGE: 208/120		BUS RATING: 100		ENCLOSURE TYPE: NEMA 1	
SHORT CIR RATING: 10 KAIC		BUS TYPE: <input checked="" type="checkbox"/> COPPER <input type="checkbox"/> ALUMINUM		MOUNTING: <input checked="" type="checkbox"/> SURFACE <input type="checkbox"/> FLUSH	
O.C. DEVICES: <input type="checkbox"/> BOLT-ON <input checked="" type="checkbox"/> PLUG-ON		DEVICE FAMILY: <input type="checkbox"/> SUB-FEED CIRCUIT BREAKER - SEE ONE LINE		INTERIOR: <input checked="" type="checkbox"/> MAIN LUGS <input type="checkbox"/> MAIN CIRCUIT BREAKER - SEE ONE LINE	


DESCRIPTION	LTG	SE	VOLT - AMPS	BRK.	CKT NO.	BUS CONN.	CKT NO.	BRK.	VOLT - AMPS	SE	DESCRIPTION
			ΦA ΦB ΦC			A B C			ΦA ΦB ΦC		
1	X	X	3600		1						SPACE 35
2	X	X	3600		2				1800		SPACE 35
3	X	X	3600		4				3600		SPACE 27
4	X	X	3600		6				1800		SPACE 26
5	X	X	3600		8				1800		SPACE 26
6	X	X	3600		10				1800		SPACE 26
7	X	X	3600		12				500	X	TIME CLOCK/ SITE LTS
8	X	X	3600		14						
9	X	X	3600		16						
10	X	X	3600		18						
11	X	X	3600		20						
12	X	X	3600		22						
13	X	X	3600		24						
14	X	X	3600		26						
15	X	X	3600		28						
16	X	X	3600		30						
17	X	X	3600		32						
18	X	X	3600		34						
19	X	X	3600		36						

PANEL NAME: 8		LOCATION: 8		PANEL TYPE: <input type="checkbox"/> PANEL BOARD <input checked="" type="checkbox"/> LOAD CENTER	
VOLTAGE: 208/120		BUS RATING: 100		ENCLOSURE TYPE: NEMA 1	
SHORT CIR RATING: 10 KAIC		BUS TYPE: <input checked="" type="checkbox"/> COPPER <input type="checkbox"/> ALUMINUM		MOUNTING: <input checked="" type="checkbox"/> SURFACE <input type="checkbox"/> FLUSH	
O.C. DEVICES: <input type="checkbox"/> BOLT-ON <input checked="" type="checkbox"/> PLUG-ON		DEVICE FAMILY: <input type="checkbox"/> SUB-FEED CIRCUIT BREAKER - SEE ONE LINE		INTERIOR: <input checked="" type="checkbox"/> MAIN LUGS <input type="checkbox"/> MAIN CIRCUIT BREAKER - SEE ONE LINE	

DESCRIPTION	LT	SE	VOLT - AMPS	BRK.	CKT NO.	BUS CONN.	CKT NO.	BRK.	VOLT - AMPS	DESCRIPTION
			ΦA ΦB ΦC			A B C			ΦA ΦB ΦC	
SPACE 67	X	X	3600		2		30		1800	X X SPACE 62
					3		4		1800	X X SPACE 62
					5		6		3600	X X SPACE 63
					7		8			
SPACE 64	X	X	1800		10		30		3600	X X SPACE 66
SPACE 64	X	X	1800		11					
					12					
					13					
					14					
					15					
					16					
					17		50		1800	X X SPACE 65
					18					
					19					
TOTALS			3600 1800 1800						3600 5400 5400	

BUS A 7.2 KVA
 BUS B 7.2 KVA
 BUS C 7.2 KVA
 TOTAL 21.6 KVA

SPACE 65 TAPPED OFF FEEDER

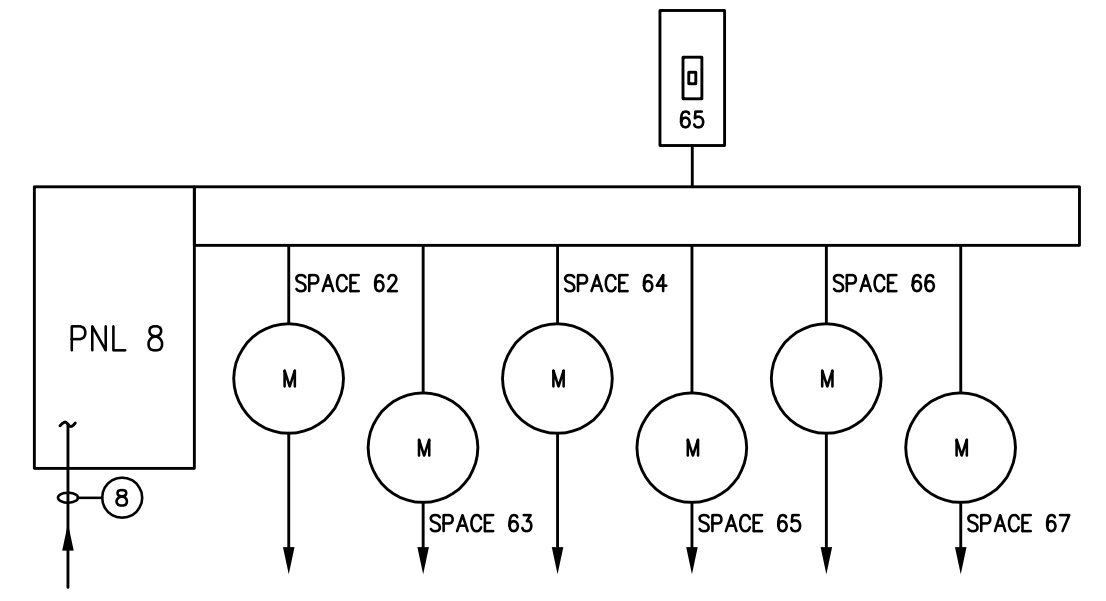


METER CABINET #8

PANEL NAME: 9		LOCATION: 9		PANEL TYPE: <input type="checkbox"/> PANEL BOARD <input checked="" type="checkbox"/> LOAD CENTER	
VOLTAGE: 208/120		BUS RATING: 100		ENCLOSURE TYPE: NEMA 1	
SHORT CIR RATING: 10 KAIC		BUS TYPE: <input checked="" type="checkbox"/> COPPER <input type="checkbox"/> ALUMINUM		MOUNTING: <input checked="" type="checkbox"/> SURFACE <input type="checkbox"/> FLUSH	
O.C. DEVICES: <input type="checkbox"/> BOLT-ON <input checked="" type="checkbox"/> PLUG-ON		DEVICE FAMILY: <input type="checkbox"/> SUB-FEED CIRCUIT BREAKER - SEE ONE LINE		INTERIOR: <input checked="" type="checkbox"/> MAIN LUGS <input type="checkbox"/> MAIN CIRCUIT BREAKER - SEE ONE LINE	

DESCRIPTION	LT	SE	VOLT - AMPS	BRK.	CKT NO.	BUS CONN.	CKT NO.	BRK.	VOLT - AMPS	DESCRIPTION
			ΦA ΦB ΦC			A B C			ΦA ΦB ΦC	
SPACE 38	X	X	3600		2		40		40	X X SPACE 40
SPACE 37	X	X	3600		4		40		3600	X X SPACE 31
SPACE 28	X	X	3600		6		40		3600	X X SPACE 39
SPACE 29	X	X	1800		100		7			X X SPACE 30
SPACE 29	X	X	1800				9			
					11					
					12		15		500	X X TIME CLOCK/ SITE LTS
					13					
					14					
					15					
					16					
					17					
					18					
					19					
TOTALS			5400 5400 3600						7200 3600 4100	

BUS A 12.6 KVA
 BUS B 9.0 KVA
 BUS C 7.7 KVA
 TOTAL 29.3 KVA

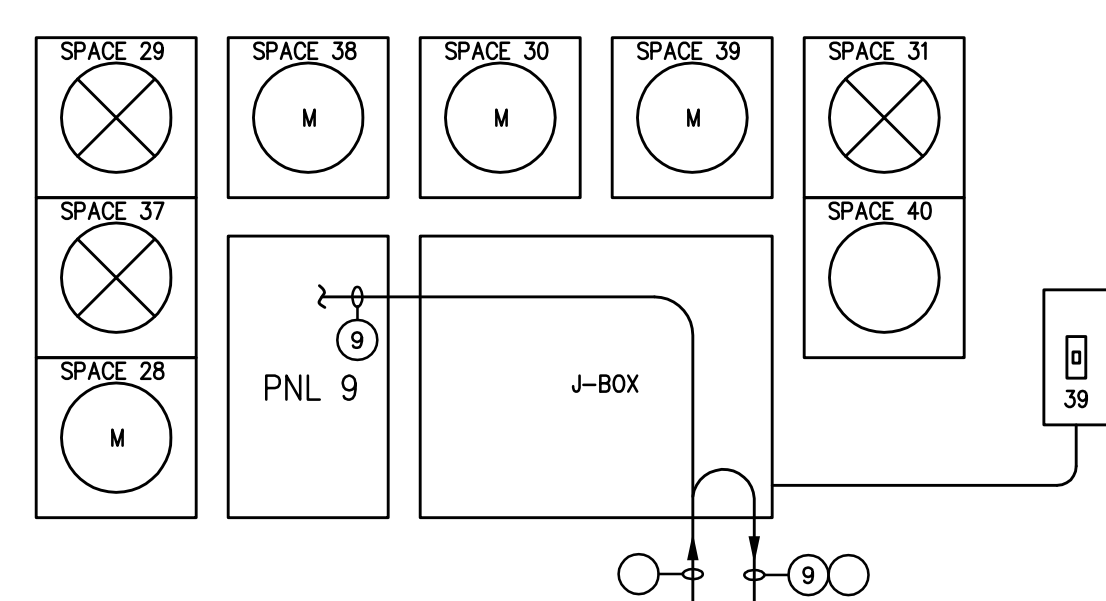


METER CABINET #9

PANEL NAME: 10		LOCATION: 10		PANEL TYPE: <input type="checkbox"/> PANEL BOARD <input checked="" type="checkbox"/> LOAD CENTER	
VOLTAGE: 208/120		BUS RATING: 100		ENCLOSURE TYPE: NEMA 1	
SHORT CIR RATING: 10 KAIC		BUS TYPE: <input checked="" type="checkbox"/> COPPER <input type="checkbox"/> ALUMINUM		MOUNTING: <input checked="" type="checkbox"/> SURFACE <input type="checkbox"/> FLUSH	
O.C. DEVICES: <input type="checkbox"/> BOLT-ON <input checked="" type="checkbox"/> PLUG-ON		DEVICE FAMILY: <input type="checkbox"/> SUB-FEED CIRCUIT BREAKER - SEE ONE LINE		INTERIOR: <input checked="" type="checkbox"/> MAIN LUGS <input type="checkbox"/> MAIN CIRCUIT BREAKER - SEE ONE LINE	

DESCRIPTION	LT	SE	VOLT - AMPS	BRK.	CKT NO.	BUS CONN.	CKT NO.	BRK.	VOLT - AMPS	DESCRIPTION
			ΦA ΦB ΦC			A B C			ΦA ΦB ΦC	
SPACE 58	X	X	3600		2		30		3600	X X SPACE 48
					4					
					6					
SPACE 56	X	X	3600		30		7			X X SPACE 46
					8					
					10		30		3600	X X SPACE 46
					12					
					13					
TIME CLOCK/ SITE LTS	X		500		20		15			X X SPACE 45
SPACE 59	X	X	3600		30		17			X X SPACE 45
					18					
					19					
					20					
					21		22		1800	X X SPACE 47
					22					
					23				1800	X X SPACE 47
					24		50		1800	X X SPACE 57
					25					
					26		50		1800	X X SPACE 57
					27				1800	X X SPACE 57
TOTALS			3600 4100 3600						7200 9000 1800	

BUS A 10.8 KVA
 BUS B 13.1 KVA
 BUS C 5.4 KVA
 TOTAL 29.3 KVA

SPACE 57 HAS METER PEDESTAL

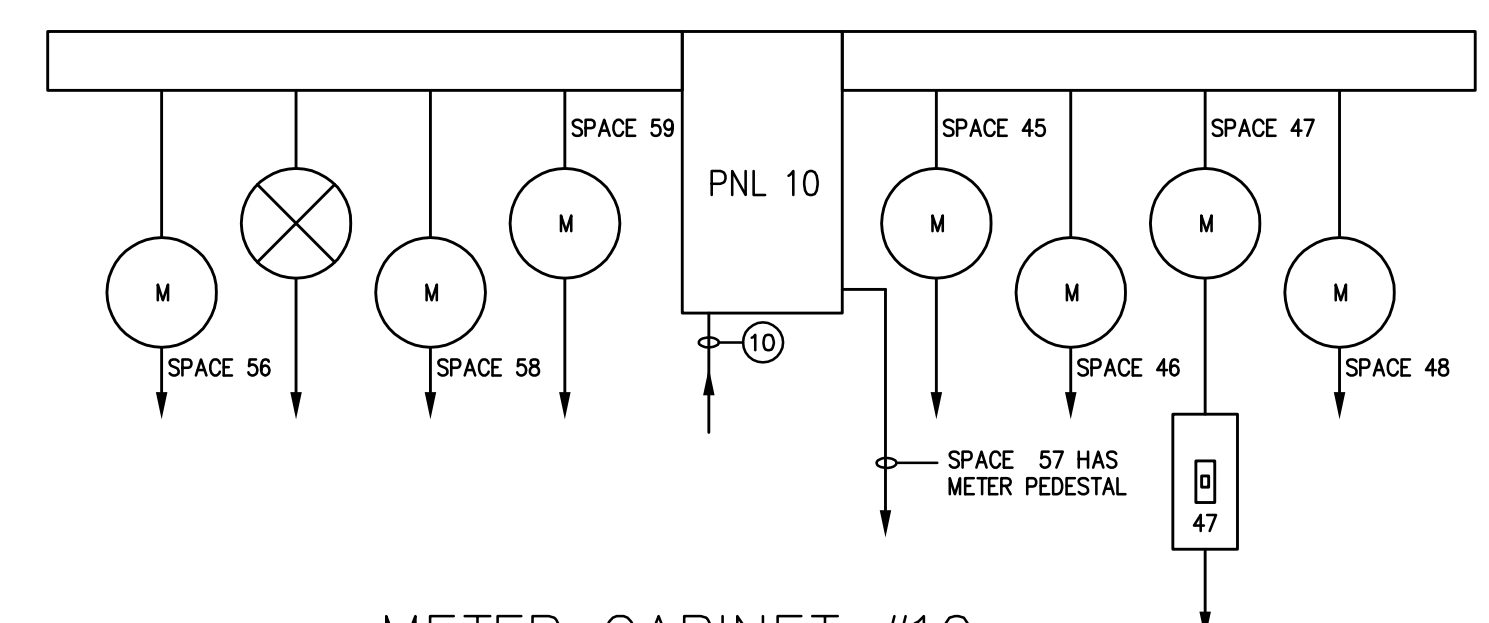

METER CABINET #10

PANEL NAME: 11		LOCATION: 11		PANEL TYPE: <input type="checkbox"/> PANEL BOARD <input checked="" type="checkbox"/> LOAD CENTER	
VOLTAGE: 208/120		BUS RATING: 100		ENCLOSURE TYPE: NEMA 1	
SHORT CIR RATING: 10 KAIC		BUS TYPE: <input checked="" type="checkbox"/> COPPER <input type="checkbox"/> ALUMINUM		MOUNTING: <input checked="" type="checkbox"/> SURFACE <input type="checkbox"/> FLUSH	
O.C. DEVICES: <input type="checkbox"/> BOLT-ON <input checked="" type="checkbox"/> PLUG-ON		DEVICE FAMILY: <input type="checkbox"/> SUB-FEED CIRCUIT BREAKER - SEE ONE LINE		INTERIOR: <input checked="" type="checkbox"/> MAIN LUGS <input type="checkbox"/> MAIN CIRCUIT BREAKER - SEE ONE LINE	

DESCRIPTION	LT	SE	VOLT - AMPS	BRK.	CKT NO.	BUS CONN.	CKT NO.	BRK.	VOLT - AMPS	DESCRIPTION
			ΦA ΦB ΦC			A B C			ΦA ΦB ΦC	
PLUG	X		1500		2		20		1500	X PLUGS
PLUG	X		1500		3		4		1500	X PLUGS
LTS	X		1000		5		6		1500	X PLUGS
LTS LAUNDRY	X		500		7		8		1500	X PLUGS
					9		20		500	X TIME CLOCK/ SITE LTS
					10					
PLUG	X		1500		12		20		1500	X PLUGS
PLUG	X		1500		13		14		1500	X PLUG
					15					
					16					
					17					
					18					
					19					
TOTALS			3500 1500 2500						4500 3500 3000	

BUS A 8.0 KVA
 BUS B 5.0 KVA
 BUS C 5.5 KVA
 TOTAL 18.5 KVA


LAUNDRY ROOM/ REC BLDG - PNL/FDR #11

PANEL NAME: 12		LOCATION: 12		PANEL TYPE: <input type="checkbox"/> PANEL BOARD <input checked="" type="checkbox"/> LOAD CENTER	
VOLTAGE: 208/120		BUS RATING: 100		ENCLOSURE TYPE: NEMA 1	
SHORT CIR RATING: 10 KAIC		BUS TYPE: <input checked="" type="checkbox"/> COPPER <input type="checkbox"/> ALUMINUM		MOUNTING: <input checked="" type="checkbox"/> SURFACE <input type="checkbox"/> FLUSH	
O.C. DEVICES: <input type="checkbox"/> BOLT-ON <input checked="" type="checkbox"/> PLUG-ON		DEVICE FAMILY: <input type="checkbox"/> SUB-FEED CIRCUIT BREAKER - SEE ONE LINE		INTERIOR: <input checked="" type="checkbox"/> MAIN LUGS <input type="checkbox"/> MAIN CIRCUIT BREAKER - SEE ONE LINE	

DESCRIPTION	LT	SE	VOLT - AMPS	BRK.	CKT NO.	BUS CONN.	CKT NO.	BRK.	VOLT - AMPS	DESCRIPTION
			ΦA ΦB ΦC			A B C			ΦA ΦB ΦC	
					1		2			
					3		4			
					5		6		30	3600 X X SPACE 49
					7		8			
SPACE 50	X	X	1800		10		40		1800	X X SPACE 60
SPACE 50	X	X	1800		11				1800	X X SPACE 60
					12					
					13					
					14					
					15					
					16					
					17					
					18					
					19					
TOTALS			0 1800 1800						1800 1800 7200	

BUS A 1.8 KVA
 BUS B 3.6 KVA
 BUS C 9.0 KVA
 TOTAL 14.4 KVA

SPACE 61 TAPPED OFF FEEDER

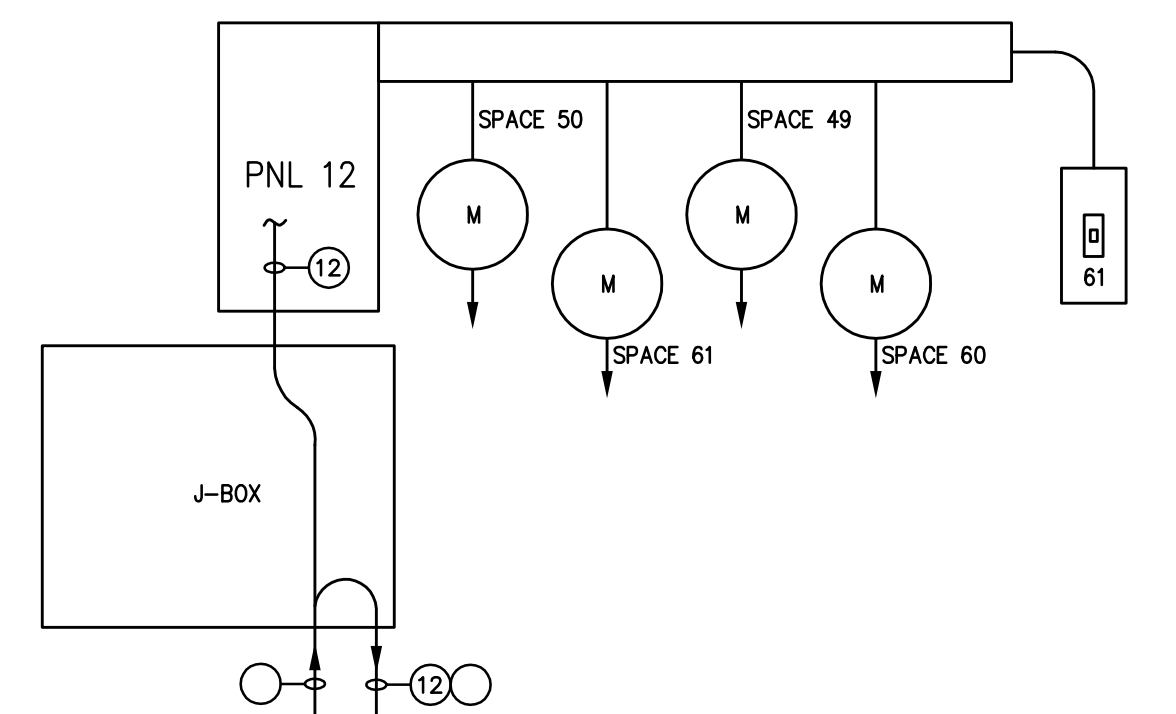


METER CABINET #12

PANEL NAME: 13		LOCATION: 13		PANEL TYPE: <input type="checkbox"/> PANEL BOARD <input checked="" type="checkbox"/> LOAD CENTER	
VOLTAGE: 208/120		BUS RATING: 100		ENCLOSURE TYPE: NEMA 1	
SHORT CIR RATING: 10 KAIC		BUS TYPE: <input checked="" type="checkbox"/> COPPER <input type="checkbox"/> ALUMINUM		MOUNTING: <input checked="" type="checkbox"/> SURFACE <input type="checkbox"/> FLUSH	
O.C. DEVICES: <input type="checkbox"/> BOLT-ON <input checked="" type="checkbox"/> PLUG-ON		DEVICE FAMILY: <input type="checkbox"/> SUB-FEED CIRCUIT BREAKER - SEE ONE LINE		INTERIOR: <input checked="" type="checkbox"/> MAIN LUGS <input type="checkbox"/> MAIN CIRCUIT BREAKER - SEE ONE LINE	

DESCRIPTION	LT	SE	VOLT - AMPS	BRK.	CKT NO.	BUS CONN.	CKT NO.	BRK.	VOLT - AMPS	DESCRIPTION
			ΦA ΦB ΦC			A B C			ΦA ΦB ΦC	
SPACE 72	X	X	3600		2		50		1800	X X SPACE 70
					3		4		1800	X X SPACE 70
SPACE 69	X	X	3600		5		6		30	NOT USED
					7		8			
SPACE 73	X	X	1800		10		30		3600	X X SPACE 71
SPACE 73	X	X	1800		11					
					12					
					13					
					14					
					15					
					16					
					17					
					18					
					19					
TOTALS			3600 1800 5400						1800 5400 0	

BUS A 5.4 KVA
 BUS B 7.2 KVA
 BUS C 5.4 KVA
 TOTAL 18.0 KVA

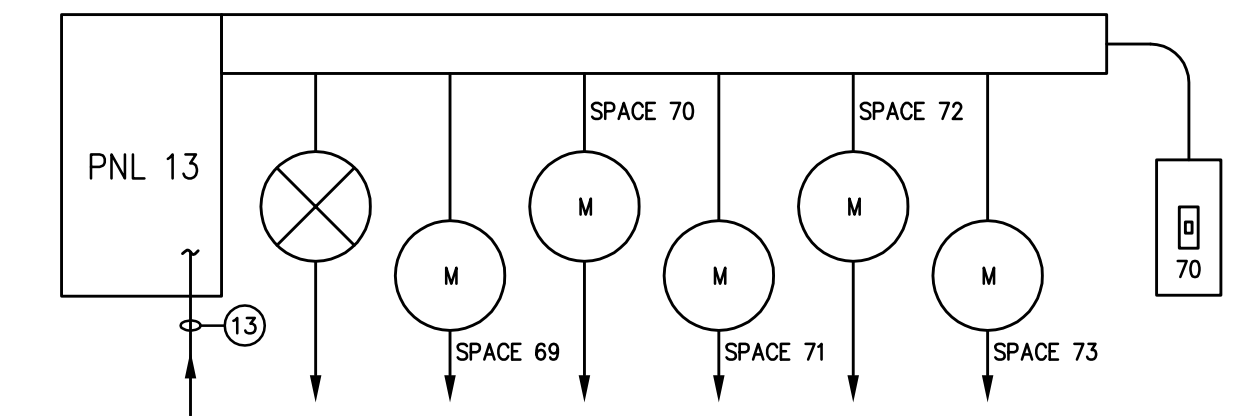

METER CABINET #13

PROPRIETARY DATA

THE USE OF THE PLANS AND SPECIFICATIONS IS LIMITED TO THE PROJECT AND SITE FOR WHICH THEY WERE PREPARED AND PUBLISHED. THEREFORE, THEY ARE NOT TO BE REPRODUCED, COPIED, OR USED FOR ANY OTHER PROJECT OR SITE WITHOUT THE WRITTEN CONSENT OF CENTRAL PACIFIC ENGINEERING, INC. WHETHER THE PROJECT FOR WHICH THE PLANS AND SPECIFICATIONS WERE PREPARED IS THE SAME OR DIFFERENT. CONTACT WITH HIGH CONSTITUTES FROM A PAGE EVIDENCE OF THE JOSS-PANOR OF THESE RESTRICTIONS. COPYRIGHT 2008 ENGINEERING, INC.

REGISTERED PROFESSIONAL ENGINEER
 DAVID GRANT SMITH
 E 13492
 EXPIRATION DATE: 08-30-16
 ELECTRICAL
 STATE OF CALIFORNIA

Central Pacific Engineering, Inc.
 Professional Engineers
 P.O. Box 1777, Capitola, CA 95010
 www.cpeinc.com

REV.	DESCRIPTION	DATE
1	SITE EVALUATION	08/10/15

TITLE: ALIMUR MOBILE HOME PARK

LOCATION: 4300 SOQUEL DR, SOQUEL, CA 95073

OWNER: DR. SLM

DATE: 08/10/15

SCALE: AS NOTED

APPD. DGS

CHKD. DGS

JOB NO. 15-024-0


DWG. NO. E4.20

SH 4 OF 5

REV. 0


METER CABINETS

PANEL NAME: 14		LOCATION: 14		PANEL TYPE: <input type="checkbox"/> PANEL BOARD <input checked="" type="checkbox"/> LOAD CENTER							
VOLTAGE: 208/120		BUS RATING: 100		ENCLOSURE TYPE: NEMA 1							
SHORT CIR RATING: 10 KAIC		BUS TYPE: <input checked="" type="checkbox"/> COPPER <input type="checkbox"/> ALUMINUM		MOUNTING: <input checked="" type="checkbox"/> SURFACE <input type="checkbox"/> FLUSH							
O.C. DEVICES: <input type="checkbox"/> BOLT-ON <input checked="" type="checkbox"/> PLUG-ON		DEVICE FAMILY: <input type="checkbox"/> SUB-FEED CIRCUIT BREAKER - SEE ONE LINE		INTERIOR: <input checked="" type="checkbox"/> MAIN LUGS <input type="checkbox"/> MAIN CIRCUIT BREAKER - SEE ONE LINE							
DESCRIPTION	LT	SE	VOLT - AMPS ΦA ΦB ΦC	BRK.	CKT NO.	BUS CONN. A B C	CKT NO.	BRK.	VOLT - AMPS ΦA ΦB ΦC	DESCRIPTION	
SPACE 76	X	X	3600		3		4	40	3600	SPACE 77	
SPACE 78	X	X	3600		5		6	20	500	TIME CLOCK/ SITE LTS	
SPACE 79	X	X	3600		7		8	40	1800	SPACE 87	
SPACE 84	X	X	1800		11		12	40	1800	SPACE 86	
SPACE 85	X	X	1800		15		16	20	500	SPACE 88	
SPACE 85	X	X	1800		17		18	20	500	SPACE 88	
SPACE 85	X	X	1800		19		20	20	500	SPACE 88	
TOTALS			7200 5400 5400						3600 7200 4600		
BUS A 10.8 KVA		BUS B 12.6 KVA		BUS C 10.0 KVA		TOTAL 33.4 KVA					

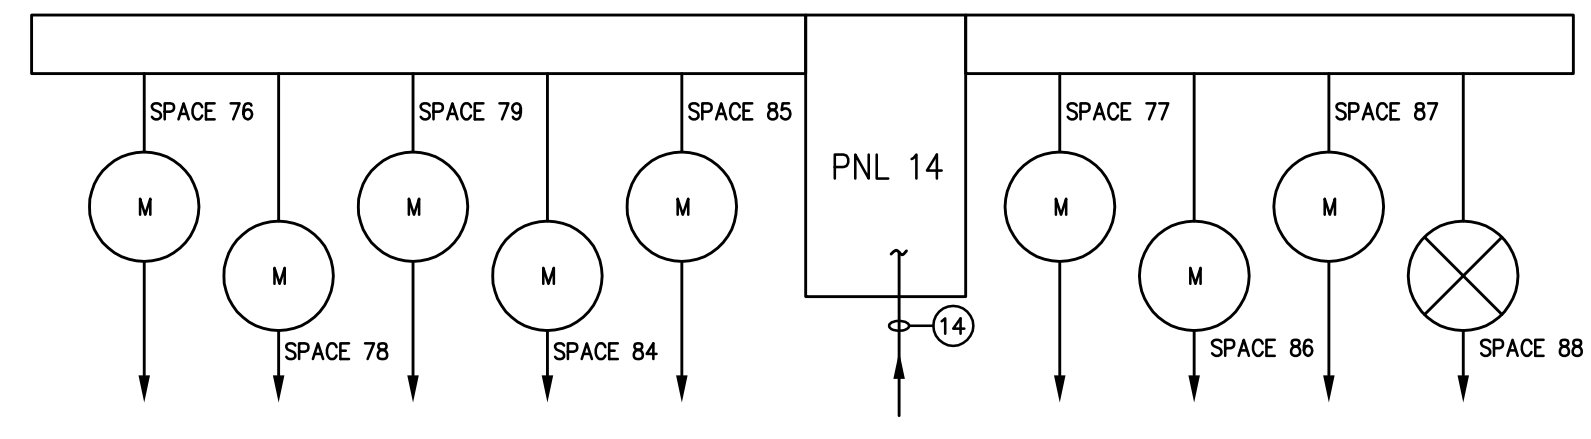


METER CABINET #14

PANEL NAME: 15		LOCATION: 15		PANEL TYPE: <input type="checkbox"/> PANEL BOARD <input checked="" type="checkbox"/> LOAD CENTER							
VOLTAGE: 208/120		BUS RATING: 100		ENCLOSURE TYPE: NEMA 1							
SHORT CIR RATING: 10 KAIC		BUS TYPE: <input checked="" type="checkbox"/> COPPER <input type="checkbox"/> ALUMINUM		MOUNTING: <input checked="" type="checkbox"/> SURFACE <input type="checkbox"/> FLUSH							
O.C. DEVICES: <input type="checkbox"/> BOLT-ON <input checked="" type="checkbox"/> PLUG-ON		DEVICE FAMILY: <input type="checkbox"/> SUB-FEED CIRCUIT BREAKER - SEE ONE LINE		INTERIOR: <input checked="" type="checkbox"/> MAIN LUGS <input type="checkbox"/> MAIN CIRCUIT BREAKER - SEE ONE LINE							
DESCRIPTION	LT	SE	VOLT - AMPS ΦA ΦB ΦC	BRK.	CKT NO.	BUS CONN. A B C	CKT NO.	BRK.	VOLT - AMPS ΦA ΦB ΦC	DESCRIPTION	
SPACE 74	X	X	3600		17		18	40	1800	SPACE 75	
TOTALS			0 0 3600						1800 0 1800		
BUS A 1.8 KVA		BUS B 0.0 KVA		BUS C 5.4 KVA		TOTAL 7.2 KVA					

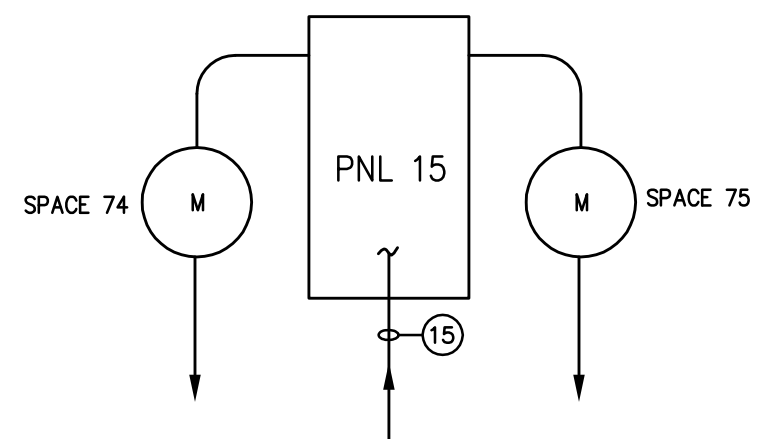

METER CABINET #15

PANEL NAME: 16		LOCATION: 16		PANEL TYPE: <input type="checkbox"/> PANEL BOARD <input checked="" type="checkbox"/> LOAD CENTER							
VOLTAGE: 208/120		BUS RATING: 100		ENCLOSURE TYPE: NEMA 1							
SHORT CIR RATING: 10 KAIC		BUS TYPE: <input checked="" type="checkbox"/> COPPER <input type="checkbox"/> ALUMINUM		MOUNTING: <input checked="" type="checkbox"/> SURFACE <input type="checkbox"/> FLUSH							
O.C. DEVICES: <input type="checkbox"/> BOLT-ON <input checked="" type="checkbox"/> PLUG-ON		DEVICE FAMILY: <input type="checkbox"/> SUB-FEED CIRCUIT BREAKER - SEE ONE LINE		INTERIOR: <input checked="" type="checkbox"/> MAIN LUGS <input type="checkbox"/> MAIN CIRCUIT BREAKER - SEE ONE LINE							
DESCRIPTION	LT	SE	VOLT - AMPS ΦA ΦB ΦC	BRK.	CKT NO.	BUS CONN. A B C	CKT NO.	BRK.	VOLT - AMPS ΦA ΦB ΦC	DESCRIPTION	
SPACE 94	X	X	1800		1		2	50	1800	SPACE 98	
SPACE 96	X	X	1800		3		4	40	1800	SPACE 98	
SPACE 96	X	X	1800		5		6	40	1800	SPACE 99	
SPACE 95	X	X	1800		7		8	40	1800	SPACE 99	
SPACE 95	X	X	1800		9		10	50	1800	SPACE 100	
SPACE 97	X	X	1800		11		12	15	500	SPACE 100	
SPACE 97	X	X	1800		13		14	15	500	SPACE 100	
SPACE 97	X	X	1800		15		16	15	500	SPACE 100	
SPACE 97	X	X	1800		17		18	15	500	SPACE 100	
SPACE 97	X	X	1800		19		20	15	500	SPACE 100	
TOTALS			5400 5400 3600						4100 3600 3600		
BUS A 9.5 KVA		BUS B 9.0 KVA		BUS C 7.2 KVA		TOTAL 25.7 KVA					

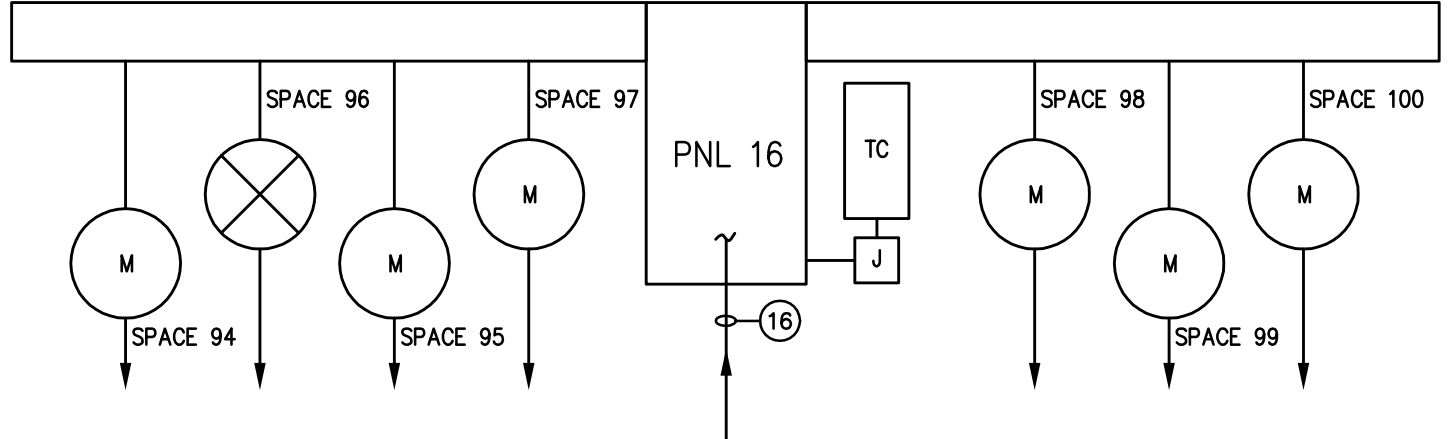


METER CABINET #16

PANEL NAME: 17		LOCATION: 17		PANEL TYPE: <input checked="" type="checkbox"/> PANEL BOARD <input type="checkbox"/> LOAD CENTER						
VOLTAGE: 208/120		BUS RATING: 125		ENCLOSURE TYPE: NEMA 1						
SHORT CIR RATING: 40KAIC		BUS TYPE: <input checked="" type="checkbox"/> COPPER <input type="checkbox"/> ALUMINUM		MOUNTING: <input checked="" type="checkbox"/> SURFACE <input type="checkbox"/> FLUSH						
O.C. DEVICES: <input checked="" type="checkbox"/> BOLT-ON <input type="checkbox"/> PLUG-ON		DEVICE FAMILY: <input type="checkbox"/> SUB-FEED CIRCUIT BREAKER		INTERIOR: <input checked="" type="checkbox"/> MAIN LUGS <input type="checkbox"/> MAIN CIRCUIT BREAKER						
DESCRIPTION	LT	SE	VOLT - AMPS ΦA ΦB ΦC	BRK.	CKT NO.	BUS CONN. A B C	CKT NO.	BRK.	VOLT - AMPS ΦA ΦB ΦC	DESCRIPTION
(Table content is crossed out with a large X)										
TOTALS			0 0						7200 7700	
BUS A 7.2 KVA		BUS B 7.7 KVA		TOTAL 14.9 KVA						


METER CABINET #17

PANEL NAME: 18		LOCATION: 18		PANEL TYPE: <input type="checkbox"/> PANEL BOARD <input checked="" type="checkbox"/> LOAD CENTER							
VOLTAGE: 208/120		BUS RATING: 100		ENCLOSURE TYPE: NEMA 1							
SHORT CIR RATING: 10 KAIC		BUS TYPE: <input checked="" type="checkbox"/> COPPER <input type="checkbox"/> ALUMINUM		MOUNTING: <input checked="" type="checkbox"/> SURFACE <input type="checkbox"/> FLUSH							
O.C. DEVICES: <input type="checkbox"/> BOLT-ON <input checked="" type="checkbox"/> PLUG-ON		DEVICE FAMILY: <input type="checkbox"/> SUB-FEED CIRCUIT BREAKER - SEE ONE LINE		INTERIOR: <input checked="" type="checkbox"/> MAIN LUGS <input type="checkbox"/> MAIN CIRCUIT BREAKER - SEE ONE LINE							
DESCRIPTION	LT	SE	VOLT - AMPS ΦA ΦB ΦC	BRK.	CKT NO.	BUS CONN. A B C	CKT NO.	BRK.	VOLT - AMPS ΦA ΦB ΦC	DESCRIPTION	
SPACE 68A	X	X	1800		4		5	60	1800	SPACE 68	
SPACE 68A	X	X	1800		6		7	60	1800	SPACE 68	
SPACE 68A	X	X	1800		8		9	60	1800	SPACE 68	
SPACE 68A	X	X	1800		10		11	60	1800	SPACE 68	
SPACE 68A	X	X	1800		12		13	60	1800	SPACE 68	
SPACE 68A	X	X	1800		14		15	60	1800	SPACE 68	
SPACE 68A	X	X	1800		16		17	60	1800	SPACE 68	
SPACE 68A	X	X	1800		18		19	60	1800	SPACE 68	
SPACE 68A	X	X	1800		20		21	60	1800	SPACE 68	
TOTALS			0 0 0						14400 0 14400		
BUS A 7.2 KVA		BUS B 5.4 KVA		BUS C 1.8 KVA		TOTAL 14.4 KVA		SPACE 68 HAS METER PEDESTAL			

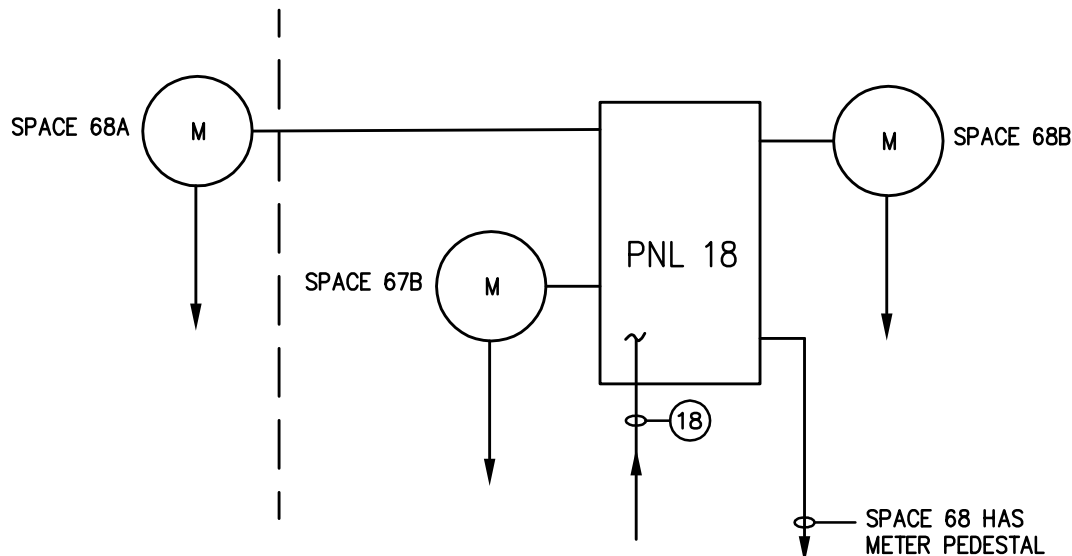

METER CABINET #18

PANEL NAME: 19		LOCATION: 19		PANEL TYPE: <input type="checkbox"/> PANEL BOARD <input checked="" type="checkbox"/> LOAD CENTER							
VOLTAGE: 208/120		BUS RATING: 100		ENCLOSURE TYPE: NEMA 1							
SHORT CIR RATING: 10 KAIC		BUS TYPE: <input checked="" type="checkbox"/> COPPER <input type="checkbox"/> ALUMINUM		MOUNTING: <input checked="" type="checkbox"/> SURFACE <input type="checkbox"/> FLUSH							
O.C. DEVICES: <input type="checkbox"/> BOLT-ON <input checked="" type="checkbox"/> PLUG-ON		DEVICE FAMILY: <input type="checkbox"/> SUB-FEED CIRCUIT BREAKER - SEE ONE LINE		INTERIOR: <input checked="" type="checkbox"/> MAIN LUGS <input type="checkbox"/> MAIN CIRCUIT BREAKER - SEE ONE LINE							
DESCRIPTION	LT	SE	VOLT - AMPS ΦA ΦB ΦC	BRK.	CKT NO.	BUS CONN. A B C	CKT NO.	BRK.	VOLT - AMPS ΦA ΦB ΦC	DESCRIPTION	
SPACE 80	X	X	1800		1		2	40	1800	SPACE 90	
SPACE 81	X	X	1800		3		4	40	1800	SPACE 90	
SPACE 81	X	X	1800		5		6	40	1800	SPACE 91	
SPACE 82	X	X	3600		7		8	40	1800	SPACE 91	
SPACE 83	X	X	1800		9		10	40	1800	SPACE 93	
SPACE 83	X	X	1800		11		12	40	1800	SPACE 93	
SPACE 83	X	X	1800		13		14	40	1800	SPACE 93	
SPACE 83	X	X	1800		15		16	40	1800	SPACE 93	
SPACE 83	X	X	1800		17		18	40	1800	SPACE 93	
SPACE 83	X	X	1800		19		20	40	1800	SPACE 93	
SPACE 83	X	X	1800		21		22	40	1800	SPACE 93	
SPACE 83	X	X	1800		23		24	40	1800	SPACE 93	
SPACE 83	X	X	1800		25		26	40	1800	SPACE 93	
SPACE 83	X	X	1800		27		28	40	1800	SPACE 93	
SPACE 83	X	X	1800		29		30	40	1800	SPACE 93	
SPACE 83	X	X	1800		31		32	40	1800	SPACE 93	
SPACE 83	X	X	1800		33		34	40	1800	SPACE 93	
SPACE 83	X	X	1800		35		36	40	1800	SPACE 93	
SPACE 83	X	X	1800		37		38	40	1800	SPACE 93	
SPACE 83	X	X	1800		39		40	40	1800	SPACE 93	
TOTALS			7200 7200 3600						3600 4100 3600		
BUS A 10.8 KVA		BUS B 11.3 KVA		BUS C 7.2 KVA		TOTAL 29.3 KVA					

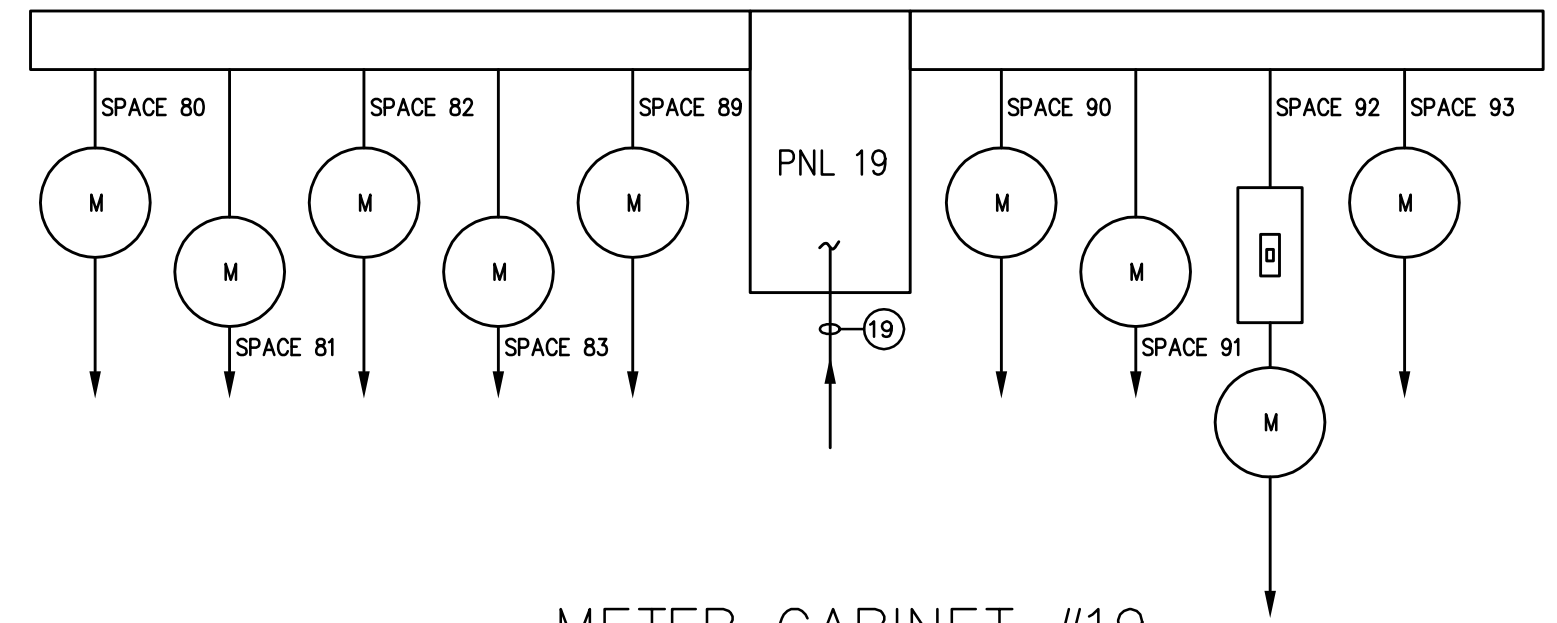

METER CABINET #19

ALIMUR MOBILE HOME PARK

LOCATION: 4300 SOQUEL DR, SOQUEL, CA 95073
 OWNER: DR. SLM
 DATE: 08/10/15
 SCALE: AS NOTED
 APPD. DGS
 CHK. DGS
 JOB NO. 15-024-0
 DWG. NO. E4.30
 SH 5 OF 5 REV. 0

METER CABINETS

PROPRIETARY DATA

THE USE OF THE PLANS AND SPECIFICATIONS IS LIMITED TO THE PROJECT FOR WHICH THEY WERE PREPARED AND PUBLISHED THEREOF. ANY OTHER USE OR REPRODUCTION OF THESE PLANS OR SPECIFICATIONS WITHOUT THE WRITTEN CONSENT OF THE ENGINEER IS STRICTLY PROHIBITED. THE ENGINEER ASSUMES NO LIABILITY FOR ANY DAMAGE OR INJURY TO PERSONS OR PROPERTY ARISING FROM THE USE OF THESE PLANS OR SPECIFICATIONS. THE ENGINEER'S LIABILITY IS LIMITED TO THE PROFESSIONAL SERVICE PROVIDED AND DOES NOT INCLUDE THE DESIGN OF STRUCTURES OR EQUIPMENT. THE USER OF THESE PLANS AND SPECIFICATIONS SHALL BE RESPONSIBLE FOR OBTAINING ALL NECESSARY PERMITS AND FOR THE ACCURACY OF THE INFORMATION PROVIDED BY OTHERS. THE ENGINEER'S LIABILITY IS LIMITED TO THE PROFESSIONAL SERVICE PROVIDED AND DOES NOT INCLUDE THE DESIGN OF STRUCTURES OR EQUIPMENT. THE USER OF THESE PLANS AND SPECIFICATIONS SHALL BE RESPONSIBLE FOR OBTAINING ALL NECESSARY PERMITS AND FOR THE ACCURACY OF THE INFORMATION PROVIDED BY OTHERS.

REGISTERED PROFESSIONAL ENGINEER
 DAVID GRANT SMITH
 E 13492
 EXPIRATION DATE: 08-30-16
 ELECTRICAL
 STATE OF CALIFORNIA

Central Pacific Engineering, Inc.
 Professional Engineers
 P.O. Box 1777, Capitola, CA 95010
 www.cpeinc.com